

LABOR AND MATERIALS

1	Copper	} Connection	3/4"	\$ 3.08		
1	Lead					
1	Curb	} Cock Valve T.S. & V.	3/4 in.	\$ 3.89		
1	Service box					
Old returned						
			Short 3 1/2 x 4 1/2	\$ 4.32		
			Long 4 1/2 x 5 1/2			
			Buff or Rdway			
20	3/4 in.	} Copper G.I. G.I.	Pipe at 4.5	\$ 9.00		
	Nipples	in.	at	\$		
	Bushings	to	in.	at	\$	
	Red'g Inc'g	} Coupl'gs.	to	in.	at	\$
	Union		in.	at	\$	
	Meter	in.	at	\$		
	Lead Joints	at		\$		
	Compound Joints	at		\$		
	Maintenance Foreman			\$		
	Hrs. Water Maint. Man	1 at		\$		
8	Hrs. Water Maint. Man	2 at	1.48	\$ 11.85		
1	Hrs. Garage Foreman	at	2.03	\$ 4.07		
2	Hrs. Labor	at	1.30	\$ 2.60		
half	Hrs. Compressor	at	5.33	\$ 16.00		
	Compensation Ins.	at \$ 5.68 per C		\$ 1.96		
	Trucking			\$ 1.50		
	Pay't Patch			\$ 8.10		
	Tap by Haj-eau & Co			\$		
	7-9-56			\$		
	O'head			\$		
				\$ 6.29		

Oneida


St. ~~Pt.~~ Ave. No. 13

Name of Owner

Charles H. White, Jr.

Labor and Mat'l. Report

July 9 19 56

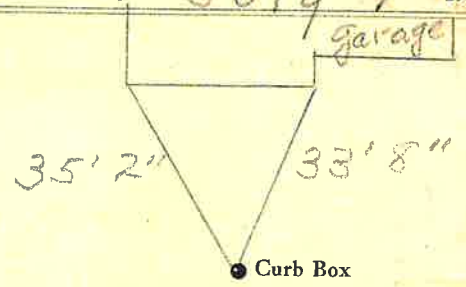

● Curb Box

UNCAS ST.

6" Main

Elev. of Main at tap 4'

Gate at ●

● Gate at

TAX ID# 303.13-15-11

● Curb Box

Tap on UNCAS ST.