


Labor and Materials

..	Copper	Connection.....	3	1.48
..	Lead		4	
..	Curb	{ Cock Valve }	2	1.79
		{ T.S.&V. }		
..	Service Box	{ Short 3 1/2 x 4 1/2 }	4	1.30
..	Old returned	{ Long 4 1/2 x 5 1/2 }		
		{ Both for Rawley }		
25	Ft.....	{ Copper Galv. Iron } Pipe at	3	1.98
		{ Cast Iron }	4	
.....	Nipples	in. at		
.....	Bushings	to	in. at	
.....	Red'g Inc'g	{ Couplings.....	to	in. at
.....	Union.....	in. at		
.....	Meter.....	in. at		
.....	Lbs. Br. Stone	at		
.....	Lbs. Sand	at		
.....	Bags Cement	at		
.....	Paving Brick	{ Mack Red Asphalt } at		
.....	Lead Joints	at		
.....	Leadite Joints	at		
3	Hrs. Foreman	at		1.88
4	Hrs. Common Labor	at		1.80
.....	Hrs. Common Labor	at		
.....	Hrs. Mason	at		
.....	Hrs. Masons Helper	at		
.....	Hrs. Compressor	at		
.....	Compensation Ins		1.12
.....	Trucking		1.12
.....	Builders Use of Water		2.50
Total \$.				13.85

32-112

Labor and Material Report *Sept 15 1932*

124 507 Oneida St.

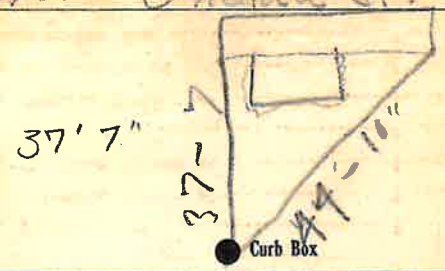

4 Main Elev. of Main at tap 4
 Gate at ● Gate at ●

● Curb Box
Old tap shut off
 TAX ID# 303.13-12-8

CR 9/15