


LABOR AND MATERIALS

Copper	} Connection	_____	\$ _____		
Lead					
Curb	} Cock	} _____ in.	\$ _____		
				} Valve	}
Service box	} Short $3\frac{1}{2}$ x $4\frac{1}{2}$	} _____	\$ _____		
Old returned				} Long $4\frac{1}{2}$ x $5\frac{1}{2}$	}
9 Ft. $3\frac{1}{4}$ in.	} Copper	} Pipe at ?	\$ _____		
				} G. I.	}
Nipples	_____ in.	at _____	\$ _____		
Bushings	_____ to _____	in. at _____	\$ _____		
Red'g	} Coupl'gs	} _____ to _____	} in. at _____		
Inc'g					
Union	_____ in.	at _____	\$ _____		
Meter	_____ in.	at _____	\$ _____		
Lead Joints	at _____		\$ _____		
Compound Joints	at _____		\$ _____		
Maintenance Foreman			\$ _____		
Hrs. Water Maint. Man-1	at _____		\$ _____		
Hrs. Water Maint. Man-2	at _____		\$ _____		
Hrs. Garage Foreman	at _____		\$ _____		
Hrs. Labor	_____ at _____		\$ _____		
Hrs. Compressor	at _____		\$ _____		
Compensation Ins.	at \$ _____	per C _____	\$ _____		
Trucking			\$ _____		
Pav't Patch			\$ _____		
<i>Measured in By</i>					
O'head	<i>Sifford</i>	<i>9/24/74</i>	\$ _____		

St.
Pl.
Ave. No. 15

Name of Owner St. John

Measured in Sept 24 1974
Labor and Mat'l. Report

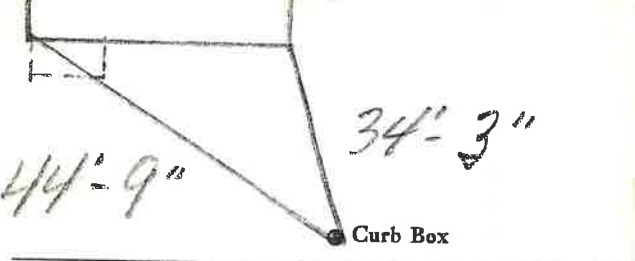

6" Main Elev. of Main at tap 5'

Gate at ● ● Gate at

TAX ID# 303.13-15-10

● Curb Box