

### LABOR AND MATERIALS

Copper	} Connection	_____	\$ _____		
Lead					
Curb	} Cock Valve T. S. & V.	_____ in.	\$ _____		
				} Service box	Short 3½ x 4½
Old returned		_____	\$ _____		
Ft. <u>3/4</u> in.	} Pipe at	_____	\$ _____		
				Copper <del>C.I.</del> C.I.	
Nipples	in. at	_____	\$ _____		
Bushings	to _____ in. at	_____	\$ _____		
Red'g Inc'g	} Coupl'gs	to _____ in. at	\$ _____		
Union				in. at	_____
Meter	in. at	_____	\$ _____		
Compound Joints	at	_____	\$ _____		
Maintenance Foreman	_____	_____	\$ _____		
Hrs. Water Maint. Man	—1 at	_____	\$ _____		
Hrs. Water Maint. Man	—2 at	_____	\$ _____		
Hrs. Garage Foreman	at	_____	\$ _____		
Hrs. Labor	— at	_____	\$ _____		
Hrs. Compressor	at	_____	\$ _____		
Trucking	_____	_____	\$ _____		
Pav't Patch	_____	_____	\$ _____		
		_____	\$ _____		
		_____	\$ _____		

ORCHARD

St.  
~~Pl.~~  
Ave. No. 36

Name of Owner \_\_\_\_\_

Labor and Mat'l. Report \_\_\_\_\_

1992

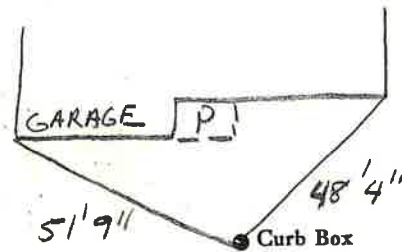

Main	Elev. of Main at tap _____
Gate at ●	● Gate at

● Curb Box

TAX ID# 303.17-6-1