


LABOR AND MATERIALS

Copper } Connection _____ \$ _____
 Lead }
 Curb } Cock _____ in. \$ _____
 } Valve _____
 } T.S. & V. _____
 Service box { Short 3-1/2 x 4-1/2 } _____ \$ _____
 Old returned { Long 4-1/2 x 5-1/2 } _____
 8- Ft. _____ in. { Copper } Pipe at _____ \$ _____
 } G.I.
 } C.I.
 Nipples _____ in. at _____ \$ _____
 Bushings _____ to _____ in. at _____ \$ _____
 Red'g _____
 Inc'g _____
 Union _____ in. at _____ \$ _____
 Meter _____ in. at _____ \$ _____
 _____ \$ _____
 Compound Joints at _____ \$ _____
 Maintenance Foreman _____ \$ _____
 Hrs. Water Maint. Man - 1 at _____ \$ _____
 Hrs. Water Maint. Man - 2 at _____ \$ _____
 Hrs. Garage Foreman _____ at _____ \$ _____
 Hrs. Labor _____ at _____ \$ _____
 Hrs. Compressor at _____ \$ _____
 _____ \$ _____
 Trucking _____ \$ _____
 Pav't Patch _____ \$ _____
 _____ \$ _____
 _____ \$ _____
 _____ \$ _____
 _____ \$ _____

ABRAHAM WING SCHOOL

ORCHARD STREET ^{St.} PL. TAP ^{Ave. No.} 37-39

Name of Owner
TAP LOCATED NEAR 37-39 ORCHARD ST.
Labor and Mat'l. Report 19

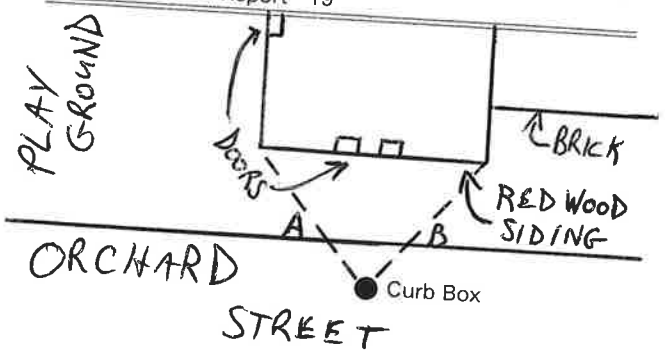

_____ Main Elev. of Main at tap _____
 Gate at ● Gate at ●
 A = 42'6" B = 41'4"
 ● Curb Box

TAX ID# 303.17-7-4