

LABOR AND MATERIALS

Copper } Connection	_____	\$	_____
Lead } _____	_____	\$	_____
Curb } Cock	} _____ in.	\$	_____
} Valve			
} T. S. & V.			
Service box } Short 3 1/2 x 4 1/2	} _____	\$	_____
Old returned } Long 4 1/2 x 5 1/2			
Ft. 3/4 in. } Copper	} Pipe at _____	\$	_____
} G.I.			
} G.I.			
Nipples _____ in. at _____	\$	_____	
Bushings _____ to _____ in. at _____	\$	_____	
Red'g } Coupl'gs _____ to _____ in. at _____	\$	_____	
Inc'g }			
Union _____ in. at _____	\$	_____	
Meter _____ in. at _____	\$	_____	
_____	\$	_____	
Compound Joints at _____	\$	_____	
Maintenance Foreman _____	\$	_____	
Hrs. Water Maint. Man-1 at _____	\$	_____	
Hrs. Water Maint. Man-2 at _____	\$	_____	
Hrs. Garage Foreman _____ at _____	\$	_____	
Hrs. Labor _____ at _____	\$	_____	
Hrs. Compressor at _____	\$	_____	
_____	\$	_____	
Trucking _____	\$	_____	
Pav't Patch _____	\$	_____	
_____	\$	_____	
_____	\$	_____	
_____	\$	_____	
_____	\$	_____	

ORCHARD


St. ~~Pl.~~ No. 42

Name of Owner

HAMMOND

Labor and Mat'l. Report

19 94

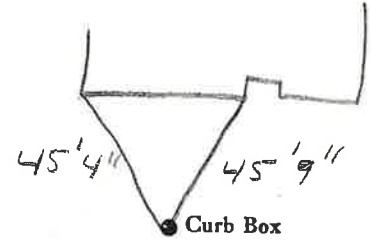

Main

Elev. of Main at tap

Gate at ●

● Gate at

● Curb Box

TAX NO# 303.17-6-3