

LABOR AND MATERIALS

3/4 Copper } Connection _____ \$ _____
 Lead }
 Curb } Cock _____ in. _____ \$ _____
 T.S. & V. }
 Service box { Short 3-1/2 x 4-1/2 } _____ \$ _____
 Old returned { Long 4-1/2 x 5-1/2 }
 3/8 Ft. _____ in. { Copper } Pipe at _____ \$ _____
 G.I. }
 C.I. }
 Nipples _____ in. at _____ \$ _____
 Bushings _____ to _____ in. at _____ \$ _____
 Red'g _____
 Inc'g _____
 Union _____ in. at _____ \$ _____
 Meter _____ in. at _____ \$ _____
 _____ \$ _____
 Compound Joints at _____ \$ _____
 Maintenance Foreman _____ \$ _____
 Hrs. Water Maint. Man - 1 at _____ \$ _____
 Hrs. Water Maint. Man - 2 at _____ \$ _____
 Hrs. Garage Foreman _____ at _____ \$ _____
 Hrs. Labor _____ at _____ \$ _____
 Hrs. Compressor at _____ \$ _____
 _____ \$ _____
 Trucking _____ \$ _____
 Pav't Patch _____ \$ _____
 _____ \$ _____
 _____ \$ _____
ORchard


St. 46
Pl.
Ave. No.

Name of Owner

TAX ID # 303.17-6-5

Labor and Mat'l. Report

12/6/2005

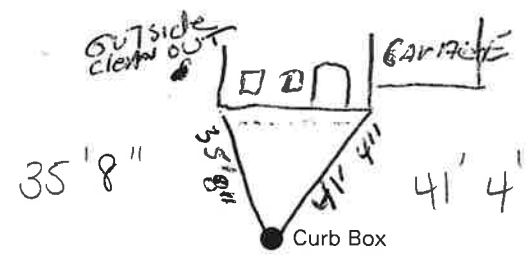

6" Main

Elev. of Main at tap 4'8"

Gate at ●

● Gate at

SEWER MAIN
3'10"

● Curb Box BOX
44' CURB
TO SEWER
MAIN