

LABOR AND MATERIALS


<u>3/4</u>	Copper Lead	} Connection		\$	
	Curb	} Cock Valve T.S. & V.	in.	\$	
	Service box	{ Short 3-1/2 x 4-1/2 Long 4-1/2 x 5-1/2 }		\$	
	Old returned				
<u>30</u>	Ft.	in.	{ Copper G.I. C.I. }	Pipe at	\$
	Nipples		in.	at	\$
	Bushings		to	in.	at \$
	Red'g				
	Inc'g				
	Union		in.	at	\$
	Meter		in.	at	\$
					\$
	Compound Joints			at	\$
	Maintenance Foreman				\$
	Hrs. Water Maint. Man - 1			at	\$
	Hrs. Water Maint. Man - 2			at	\$
	Hrs. Garage Foreman			at	\$
	Hrs. Labor			at	\$
	Hrs. Compressor			at	\$
					\$
	Trucking				\$
	Pav't Patch				\$
					\$
					\$
					\$
					\$

Orchard

St. Pl. Ave. No. 48

Name of Owner
TAX ID# 303.17-6-6

Labor and Mat'l, Report 8/2005

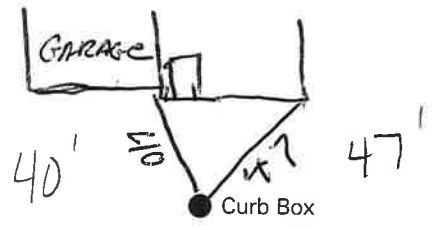

6 Main

Elev. of Main at tap 4' 11"

