


LABOR AND MATERIALS

3/4	Copper Lead	Connection	_____	\$	_____
_____	Curb	Cock Valve T.S. & V.	_____ in.	\$	_____
_____	Service box	{ Short 3-1/2 x 4-1/2 Old returned Long 4-1/2 x 5-1/2 }	_____	\$	_____
24	Ft. _____ in.	{ Copper G.I. C.I. }	Pipe at _____	\$	_____
_____	Nipples	_____ in.	at _____	\$	_____
_____	Bushings	_____ to _____ in.	at _____	\$	_____
_____	Red'g	_____	_____	\$	_____
_____	Inc'g	_____	_____	\$	_____
_____	Union	_____ in.	at _____	\$	_____
_____	Meter	_____ in.	at _____	\$	_____
_____	Compound Joints	at _____	_____	\$	_____
_____	Maintenance Foreman	_____	_____	\$	_____
_____	Hrs. Water Maint. Man - 1	at _____	_____	\$	_____
_____	Hrs. Water Maint. Man - 2	at _____	_____	\$	_____
_____	Hrs. Garage Foreman	_____ at _____	_____	\$	_____
_____	Hrs. Labor	_____ at _____	_____	\$	_____
_____	Hrs. Compressor	at _____	_____	\$	_____
_____	Trucking	_____	_____	\$	_____
_____	Pav't Patch	_____	_____	\$	_____
_____	_____	_____	_____	\$	_____
_____	_____	_____	_____	\$	_____
ORchard St. Ave. No. 50

Name of Owner TAX ID # 303.17-6-7

Labor and Mat'l. Report # 6/2005

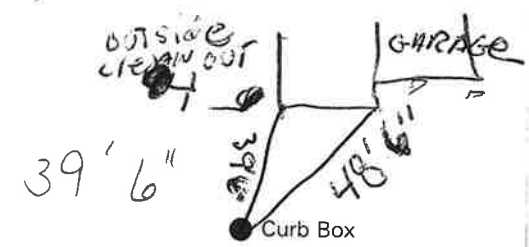

6" Main Elev. of Main at tap 4'11"

Gate at ● Gate at Sewer MAIN 4'6"

● Curb Box 41' CURB BOX TO SEWER MAIN WITH