


### LABOR AND MATERIALS

3/4	Copper } Connection _____ \$ _____	
	Lead } _____ \$ _____	
	Curb } Cock } _____ in. _____ \$ _____	
		Valve } _____ \$ _____
		T.S. & V. } _____ \$ _____
	Service box { Short 3-1/2 x 4-1/2 } _____ \$ _____	
	Old returned { Long 4-1/2 x 5-1/2 } _____ \$ _____	
30'	Ft. 4 in. { Copper } Pipe at _____ \$ _____	
		G.I. } _____ \$ _____
		C.I. } _____ \$ _____
	Nipples _____ in. at _____ \$ _____	
	Bushings _____ to _____ in. at _____ \$ _____	
	Red'g _____ \$ _____	
	Inc'g _____ \$ _____	
	Union _____ in. at _____ \$ _____	
	Meter _____ in. at _____ \$ _____	
	_____ \$ _____	
	Compound Joints at _____ \$ _____	
	Maintenance Foreman _____ \$ _____	
	Hrs. Water Maint. Man - 1 at _____ \$ _____	
	Hrs. Water Maint. Man - 2 at _____ \$ _____	
	Hrs. Garage Foreman _____ at _____ \$ _____	
	Hrs. Labor _____ at _____ \$ _____	
	Hrs. Compressor at _____ \$ _____	
	_____ \$ _____	
	Trucking _____ \$ _____	
	Pav't Patch _____ \$ _____	
	_____ \$ _____	
	_____ \$ _____	
ORCHARD St. Ave. No. 52  
 Name of Owner \_\_\_\_\_  
 TAX ID# 303.13-21-1  
 Labor and Mat'l. Report 10/6/2005

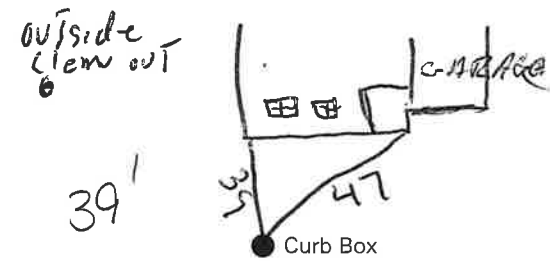

6" Main Elev. of Main at tap 5'  
 Gate at ● Gate at ●  
 Sewer 6" main  
 ● Curb Box  
 24' 6" CURB TO Sewer MAIN  
 22° + 45° bend LATERAL TO MAIN