

LABOR AND MATERIALS

Copper } Connection _____	\$ _____
Lead } _____	\$ _____
Curb } Cock Valve } _____ in.	\$ _____
} T. S. & V. }	
Service box { Short 3½ x 4½ }	\$ _____
Old returned { Long 4½ x 5½ }	
{ Buff or Rdway }	
Ft. _____ in. { Copper } Pipe at _____	\$ _____
{ G. I. }	
{ C. I. }	
Nipples _____ in. at _____	\$ _____
Bushings _____ to _____ in. at _____	\$ _____
Red'g } Coupl'gs _____ to _____ in. at _____	\$ _____
Inc'g }	
Union _____ in. at _____	\$ _____
Meter _____ in. at _____	\$ _____
Lead Joints at _____	\$ _____
Compound Joints at _____	\$ _____
Maintenance Foreman _____	\$ _____
Hrs. Water Maint. Man-1 at _____	\$ _____
Hrs. Water Maint. Man-2 at _____	\$ _____
Hrs. Garage Foreman _____ at _____	\$ _____
Hrs. Labor _____ at _____	\$ _____
Hrs. Compressor at _____	\$ _____
Compensation Ins. at \$ _____ per C _____	\$ _____
Trucking _____	\$ _____
Pav't Patch _____	\$ _____
_____	\$ _____
_____	\$ _____
_____	\$ _____
O'head _____	\$ _____
_____	\$ _____

Orchard


St.
Pl.
Ave. No. 53

Name of Owner _____

TAX ID # 303.13-22-20

Labor and Mat'l. Report _____

11-17 1986

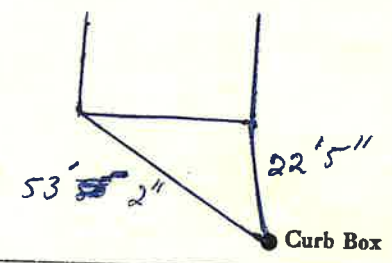

Main	Elev. of Main at tap _____
Gate at ●	● Gate at
● Curb Box	