


LABOR AND MATERIALS

1	Copper	Connection	3/4	\$
1	Curb	Cock Valve Tr. & V.	3/4 in. Stop & Waste	\$
1	Service box	Short 3/2 x 4 1/2	4'-5"	\$
Old returned	Long 1 1/2 x 5 1/2	Buff or Railway		
23	3/4 in.	Copper Pipe at		\$
		Nipples in. at		\$
		Bushings to in. at		\$
		Red'g Inc'g Coupl'gs to in. at		\$
		Union in. at		\$
		Meter in. at		\$
		Lead Joints at		\$
		Compound Joints at		\$
		Maintenance Foreman		\$
		Hrs. Water Maint. Man-1 at		\$
		Hrs. Water Maint. Man-2 at		\$
		Hrs. Garage Foreman at		\$
		Hrs. Labor at		\$
		Hrs. Compressor at		\$
		Compensation Ins. at \$ per C		\$
		Trucking		\$
		Pav't Patch		\$
		TAP BY ROCK & CO		\$
		July-29-1974		\$
		O'head		\$

Orchard St. No. 55

Name of Owner  
Dwight Coon

Labor and Mat'l. Report July 29 1974

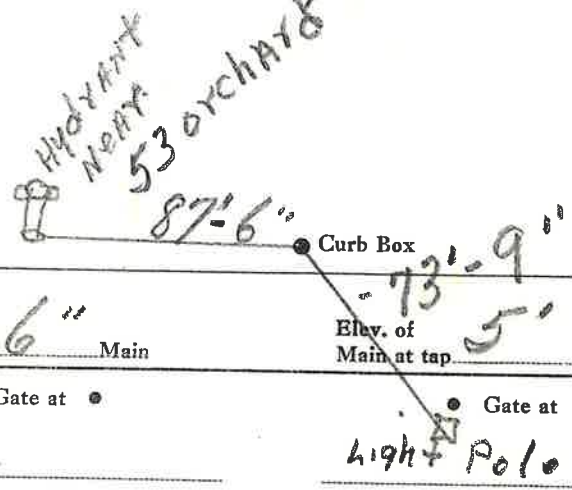

Lot TAP