


LABOR AND MATERIALS

Copper } Connection _____	\$ _____
Lead } _____	\$ _____
Curb } Cock Valve } _____ in.	\$ _____
} T. S. & V. }	
Service box } Short 3½ x 4½ }	\$ _____
Old returned } Long 4½ x 5½ }	
} Buff or Rdway }	
276" Ft. 3/4 in. } Copper } Pipe at _____	\$ _____
} G.I. }	
} G.I. }	
Nipples _____ in. at _____	\$ _____
Bushings _____ to _____ in. at _____	\$ _____
Red'g } Coupl'gs _____ to _____ in. at _____	\$ _____
Inc'g }	
Union _____ in. at _____	\$ _____
Meter _____ in. at _____	\$ _____
Lead Joints at _____	\$ _____
Compound Joints at _____	\$ _____
Maintenance Foreman _____	\$ _____
Hrs. Water Maint. Man—1 at _____	\$ _____
Hrs. Water Maint. Man—2 at _____	\$ _____
Hrs. Garage Foreman _____ at _____	\$ _____
Hrs. Labor— _____ at _____	\$ _____
Hrs. Compressor at _____	\$ _____
Compensation Ins. at \$ _____ per C	\$ _____
Trucking _____	\$ _____
Pav't Patch _____	\$ _____
_____	\$ _____
_____	\$ _____
_____	\$ _____
O'head _____	\$ _____
_____	\$ _____

St. Orchard
~~Pl.~~ Ave. No. 56

Name of Owner Ron Gindler

Labor and Mat'l. Report Oct 19 88

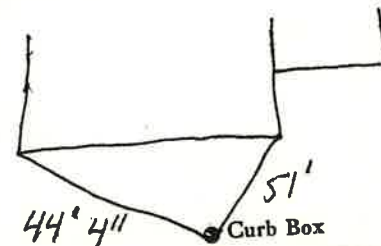

Main Elev. of
Main at tap

Gate at • • Gate at

• Curb Box

TAX ID # 303.13-21-2