


LABOR AND MATERIALS

1	Copper Lead	Connection	3/4"	\$	2.71
1	Curb	Cock Valve T.S. & V.	3/4 in.	\$	3.83
1	Service box Old returned	Short 3 1/2 x 4 1/2 Long 4 1/2 x 5 1/2 Buff or Rdway		\$	4.69
8	Ft. 3/4 in.	Copper G.I. C.I.	Pipe at 45	\$	3.60
	Nipples	in. at		\$	
	Bushings	to in. at		\$	
	Red'g Inc'g	Coupl'gs to in. at		\$	
	Union	in. at		\$	
	Meter	in. at		\$	
	Lead Joints at			\$	
	Compound Joints at			\$	
	Maintenance Foreman			\$	4.74
	Hrs. Water Maint. Man-1 at			\$	
2	Hrs. Water Maint. Man-2 at	1.24		\$	2.48
	Hrs. Garage Foreman at			\$	
2	Hrs. Labor at	1.13		\$	2.26
	Hrs. Compressor at			\$	
	Compensation Ins. at \$	4.29	per C.	\$	20
	Trucking			\$	1.50
	Pav't Patch incl. in. EST.			\$	
	Tap by Gifford 9-20-55			\$	
	O'head			\$	
				\$	21.27

St. Orchard
 Ave. No. 57

Name of Owner
Daniel Toomey

Labor and Mat'l. Report Sept 20 1955

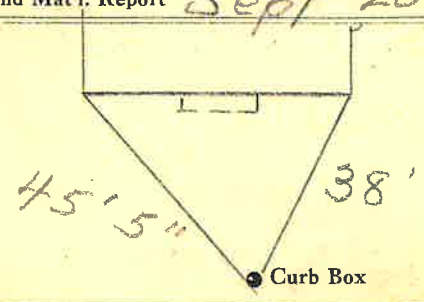

6" Main Elev. of Main at tap 5'
 Gate at • Gate at •

• Curb Box
 TAX ID # 303.13-22-19