


LABOR AND MATERIALS

1	Copper	} Connection	3/4"	\$
	Lead			
1	Curb	} Cock	3/4 in. (MARK II ORISEAL)	\$
1	Service box	} Short 3 1/2 x 4 1/2		\$
	Old returned			
29	Ft. 3/4 in.	} Copper	} Pipe at	\$
	Nipples	in. at	\$	
	Bushings	to in. at	\$	
	Red'g	} Coupl'gs. to in. at	\$	
	Inc'g			
	Union	in. at	\$	
	Meter	in. at	\$	
	Lead Joints at		\$	
	Compound Joints at		\$	
	Maintenance Foreman		\$	
	Hrs. Water Maint. Man-1 at		\$	
	Hrs. Water Maint. Man-2 at		\$	
	Hrs. Garage Foreman at		\$	
	Hrs. Labor at		\$	
	Hrs. Compressor at		\$	
	Compensation Ins. at \$	per C	\$	
	Trucking		\$	
	Pav't Patch		\$	
	TAP MADE BY GIFFORD CO			\$
	O'head	MAY-30-1973	\$	
			\$	

ORCHARD St. Ave. No. 68

Name of Owner
John D. Trombley

Labor and Mat'l. Report MAY 30 1973

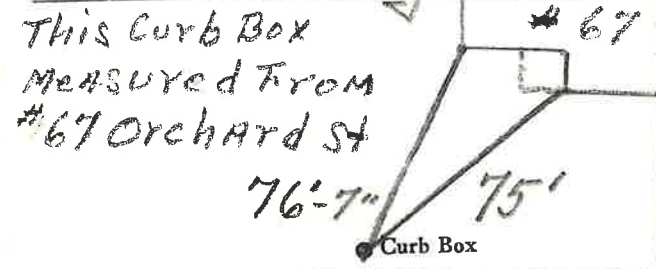

6" Main Elev. of Main at tap 5 1/2'

Gate at • Gate at •

● Curb Box

TAX ID# 303.13-21-7