

### LABOR AND MATERIALS

Copper	}	Connection		\$	
Lead					
Curb	}	Cock	} in.	\$	
		Valve			
		T. S. & V.			
Service box	}	Short $3\frac{1}{2} \times 4\frac{1}{2}$	} in.	\$	
Old returned		Long $4\frac{1}{2} \times 5\frac{1}{2}$			
Ft. $\frac{3}{4}$ in.	}	Copper	} Pipe at	\$	
		<del>C.I.</del>			
Nipples		in. at		\$	
Bushings		to in. at		\$	
Red'g	}	Coupl'gs	to in. at	\$	
Inc'g					
Union		in. at		\$	
Meter		in. at		\$	
				\$	
Compound Joints		at		\$	
Maintenance Foreman				\$	
Hrs. Water Maint. Man-1		at		\$	
Hrs. Water Maint. Man-2		at		\$	
Hrs. Garage Foreman		at		\$	
Hrs. Labor		at		\$	
Hrs. Compressor		at		\$	
				\$	
Trucking				\$	
Pav't Patch				\$	
				\$	
				\$	
				\$	
				\$	

ORCHARD


St.  
~~Pt.~~  
Ave. No. 76

Name of Owner

TAX ID # 303.13-21-11

Labor and Mat'l. Report

19 89

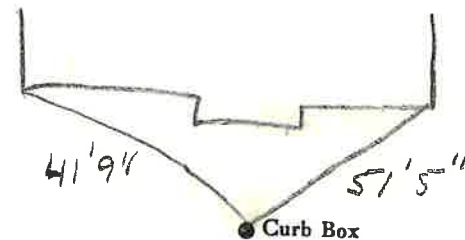

	Elev. of
Main	Main at tap
Gate at ●	● Gate at
_____	_____

● Curb Box