

### Labor and Materials

1	Copper } Connection... 3/4	\$ 3.20
1	Lead } Connection... 3/4	
	Curb { Cock Valve } 1/2 in.	\$ 1.00
	{ T.S. & V. }	
1	Service Box { Short 3 1/2 x 4 1/2 }	\$ 1.30
	Old returned { Long 4 1/2 x 5 1/2 }	
	{ Buff. or Rdway }	
11	Ft. 1/2 in. { Copper } Pipe at	\$ 2.42
	{ Galv. Iron }	
	{ Cast Iron }	
	Nipples..... in. at	\$ .08
1	Bushings 1/2 to 1/2 in. at	\$ .08
	Red'g } Couplings..... to..... in. at	\$ .
	Inc'g }	
	Union..... in. at	\$ .
	Meter..... in. at	\$ .
	Lbs. Br. Stone at	\$ .
	Lbs. Sand at	\$ .
	Bags Cement at	\$ .
	Paving Brick { Mack } at	\$ .
	{ Red }	
	{ Asphalt }	
	Lead Joints at	\$ .
	Leadite Joints at	\$ .
2	Hrs. Foreman at 6 1/2	\$ 2.25
3	Hrs. Common Labor at 50	\$ 1.50
7	Hrs. Common Labor at 40 1/2	\$ 2.84
	Hrs. Mason at	\$ .
	Hrs. Mason's Helper at	\$ .
	Hrs. Compressor at	\$ .
	Compensation Ins.....	\$ 1.2
	Trucking.....	\$ 1.00
	Builders' Use of Water.....	\$ .

Total \$14.71


27-185 17

Labor and Material Report

Oct 13

1907

no 7 Orchard St

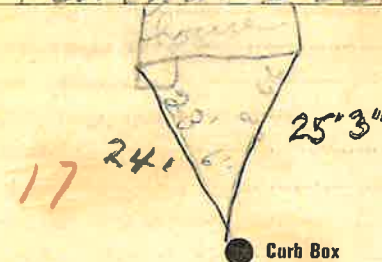

Main Elev. of Main at tap 6  
 Gate at Tax ID # 303.18-5-14 Gate at

Curb Box

Old Tap shut off.