

LABOR AND MATERIALS

Copper	} Connection _____	\$ _____	
Lead			
Curb	} Cock _____	\$ _____	
			} Valve _____
Service box	} Short 3½ x 4½ _____	\$ _____	
			} Long 4½ x 5½ _____
Old returned			
Ft. 3/4 3/4	} Copper _____	\$ _____	
in.			} G. I. _____
			} C. I. _____
Nipples	in. at _____	\$ _____	
Bushings	to _____ in. at _____	\$ _____	
Red'g	} Coupl'gs _____ to _____ in. at _____	\$ _____	
Inc'g			
Union	in. at _____	\$ _____	
Meter	in. at _____	\$ _____	
		\$ _____	
Compound Joints	at _____	\$ _____	
Maintenance Foreman		\$ _____	
Hrs. Water Maint. Man-1	at _____	\$ _____	
Hrs. Water Maint. Man-2	at _____	\$ _____	
Hrs. Garage Foreman	at _____	\$ _____	
Hrs. Labor	at _____	\$ _____	
Hrs. Compressor	at _____	\$ _____	
		\$ _____	
Trucking		\$ _____	
Pav't Patch		\$ _____	
		\$ _____	
		\$ _____	
		\$ _____	
		\$ _____	

Orchard


St. _____
~~Pl.~~ _____
 Ave. No. 80

Name of Owner

Relak

Labor and Mat'l. Report

19 90

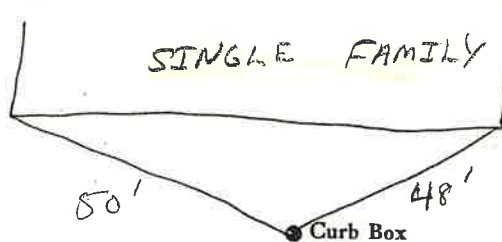

Main

Elev. of Main at tap 5'

Gate at ●

● Gate at

● Curb Box

TAX ID # 303.13-21-12