

LABOR AND MATERIALS

Copper	} Connection	_____	\$ _____	
Lead				
Curb	} Cock Valve } T. S. & V. }	_____ in.	\$ _____	
Service box		} Short 3½ x 4½ } Long 4½ x 5½ }		
Old returned				\$ _____
29 Ft. 1½ in.	} Copper } G.I. } G.I. }	Pipe at	\$ _____	
Nipples		_____ in. at	\$ _____	
Bushings		_____ to _____ in. at	\$ _____	
Red'g } Inc'g }	} Coupl'gs	_____ to _____ in. at	\$ _____	
Union		_____ in. at	\$ _____	
Meter	_____ in. at	\$ _____		
Compound Joints	at	\$ _____		
Maintenance Foreman		\$ _____		
Hrs. Water Maint. Man	— 1 at	\$ _____		
Hrs. Water Maint. Man	— 2 at	\$ _____		
Hrs. Garage Foreman	at	\$ _____		
Hrs. Labor	_____ at	\$ _____		
Hrs. Compressor	at	\$ _____		
Trucking		\$ _____		
Pav't Patch		\$ _____		
		\$ _____		
		\$ _____		
		\$ _____		
		\$ _____		

DIX + ORCHARD

St. ~~Pl.~~
Ave. No 82


Orchard

Name of Owner

TAX ID # 303.13-21-13

Labor and Mat'l. Report

19 88

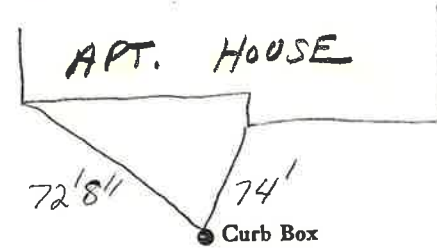

Orchard St.

Elev. of

Main

Main at tap

Gate at ●

● Gate at

● Curb Box