


LABOR AND MATERIALS

1	Copper Lead	Connection	3/4"	\$
1	Curb	Cock Valve T.S. & V.	3/4 in.	\$
1	Service box Old returned	Short 3 1/2 x 4 1/2 Long 4 1/2 x 5 1/2 Buff or Rdway		\$
10	Ft.	Copper G.I. C.I.	3/4 in. Pipe at	\$
	Nipples	in. at		\$
	Bushings	to in. at		\$
	Red'g Inc'g	Coupl'gs. to in. at		\$
	Union	in. at		\$
	Meter	in. at		\$
	Lead Joints	at		\$
	Compound Joints	at		\$
	Maintenance Foreman			\$
	Hrs. Water Maint. Man-1	at		\$
	Hrs. Water Maint. Man-2	at		\$
	Hrs. Garage Foreman	at		\$
	Hrs. Labor	at		\$
	Hrs. Compressor	at		\$
	Compensation Ins.	at \$ per C		\$
	Trucking			\$
	Pav't Patch			\$
	Tap by Giggord & Co.			\$
	5-5-60.			\$
	O'head			\$

St. Orchard
 Ph. No. 21
 Ave. No. 21

Name of Owner
 Joseph Neroni

Labor and Mat'l. Report May 5 1960

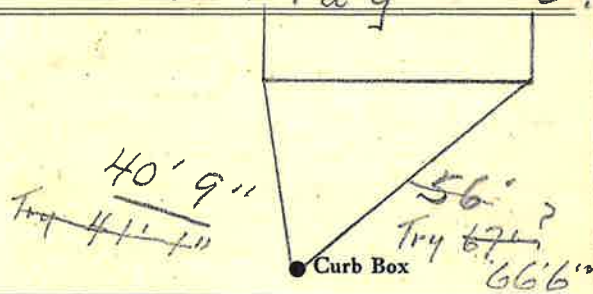

4" Main Elev. of Main at tap 5'
 Gate at • Gate at •

• Curb Box

TAX ID # 303.18-5-13