


LABOR AND MATERIALS

Copper	} Connection		\$	
Lead				
Curb	} Cock Valve T. S. & V. }	in.	\$	
Service box		} Short 3½ x 4½ Long 4½ x 5½ }		
Old returned				\$
25 3/4	} Copper G. I. C. I. }	in. Pipe at	\$	
Nipples		in. at	\$	
Bushings		to in. at	\$	
Red'g Inc'g	} Coupl'gs	to in. at	\$	
Union			in. at	\$
Meter		in. at	\$	
			\$	
Compound Joints		at	\$	
Maintenance Foreman			\$	
Hrs. Water Maint. Man-1		at	\$	
Hrs. Water Maint. Man-2		at	\$	
Hrs. Garage Foreman		at	\$	
Hrs. Labor		at	\$	
Hrs. Compressor		at	\$	
			\$	
Trucking			\$	
Pav't Patch			\$	
			\$	
			\$	
			\$	
			\$	

ORCHARD St. Pl. Ave. No. 22

Name of Owner

Labor and Mat'l. Report 1948

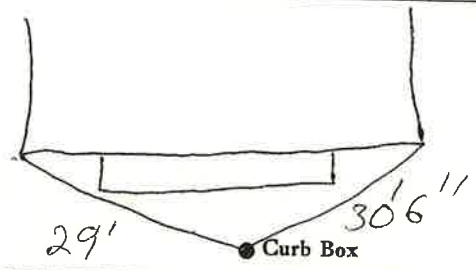

2 1/2 Main Elev. of Main at tap 6

Gate at • Gate at •

• Curb Box

TAX ID # 303.17-15-4