

LABOR AND MATERIALS


1	Copper Lead	Connection	3/4"	\$ 3.08
1	Curb	Cock Valve T.S. & V.	3/4 in.	\$ 2.89
1	Service box	Short 3 1/2 x 4 1/2		
	Old returned	Long 4 1/2 x 5 1/2		
		Buff or Rdway		\$ 4.32
24	Ft. 3/4 in.	Copper G.I. Pipe at	4.5	\$ 10.80
	Nipples	in. at		\$
	Bushings	to in. at		\$
	Red'g } Inc'g }	Coupl'gs	to in. at	\$
	Union	in. at		\$
	Meter	in. at		\$
	Lead Joints	at		\$
	Compound Joints	at		\$
	Maintenance Foreman			\$
	Hrs. Water Maint. Man-1	at		\$
19	Hrs. Water Maint. Man-2	at 1.613		\$ 20.65
	Hrs. Garage Foreman	at		\$
35	Hrs. Labor	at 1.30		\$ 45.50
	Hrs. Compressor	at		\$
	Compensation Ins.	at \$ 5.646 per C		\$ 4.33
	Trucking			\$ 1.50
	Pay't Patch			\$ 24.64
	Tap made Sept 18-56			\$
	G. S. Ford & Co.			\$
	O'head			\$
				\$ 128.71

104-07

Orchard St. Pl. Ave. No. 24

Name of Owner Kennedy

Labor and Mat'l. Report Sept 18 1956

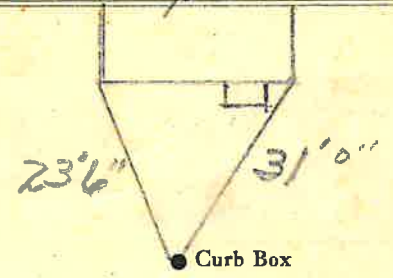

4" Main Elev. of Main at tap 5 1/2'

Gate at • Gate at

TAX ID# 303.17-15-5

• Curb Box

Old Service Disconnected