


LABOR AND MATERIALS

1 Copper } Connection 3/4" \$  
~~Steel~~ }  
 1 Curb } Cock } 3/4 in. (MARK II ORIGINAL)  
 } Valve }  
 } }  
 1 Service box } Short 3 1/2 x 4 1/2 }  
 Old returned } Long 4 1/2 x 5 1/2 }  
 } Buff or Rdway } \$  
 27 Ft. 3/4 in. } Copper } Pipe at \$  
 } }  
 Nipples in. at \$  
 Bushings to in. at \$  
 Red'g } Coupl'gs to in. at \$  
 Inc'g }  
 Union in. at \$  
 Meter in. at \$  
 Lead Joints at \$  
 Compound Joints at \$  
 Maintenance Foreman \$  
 Hrs. Water Maint. Man-1 at \$  
 Hrs. Water Maint. Man-2 at \$  
 Hrs. Garage Foreman at \$  
 Hrs. Labor at \$  
 Hrs. Compressor at \$  
 Compensation Ins. at \$ per C \$  
 Trucking \$  
 Pav't Patch \$  
 TAP MADE BY PECK & CO \$  
 O'head OCT-16-1972 \$

St. ORMOND  
 Pt. Ave. No. 1

Name of Owner HARRY BERKOWITZ

Labor and Mat'l. Report OCT 16 1972

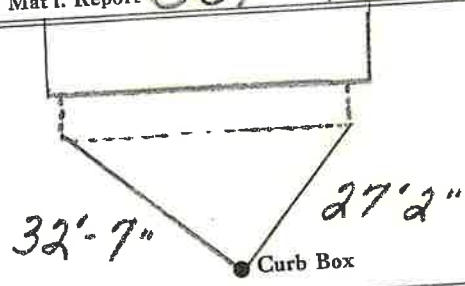

6" Main Elev. of Main at tap 4 1/2

Gate at • Gate at •

TAX ID# 309.27-2-19

• Curb Box