


LABOR AND MATERIALS

1 Copper } Connection 3/4" \$  
 1 Curb } Cock 3/4 in. MARK II EXISEAL \$  
 1 Service box } Short 3 1/2 x 4 1/2 }  
 Old returned } Long 4 1/2 x 5 1/2 }  
 } Buff or Rdway } \$  
 10 Ft. 3/4 in. } Copper } Pipe at \$  
 } }  
 Nipples in. at \$  
 Bushings to in. at \$  
 Red'g }  
 Inc'g } Coupl'gs to in. at \$  
 Union in. at \$  
 Meter in. at \$  
 Lead Joints at \$  
 Compound Joints at \$  
 Maintenance Foreman \$  
 Hrs. Water Maint. Man-1 at \$  
 Hrs. Water Maint. Man-2 at \$  
 Hrs. Garage Foreman at \$  
 Hrs. Labor at \$  
 Hrs. Compressor at \$  
 Compensation Ins. at \$ per C \$  
 Trucking \$  
 Pav't Patch \$  
 Tap made by Pock 4C \$  
 O'head Oct-14-1972 \$

St. ORMOND  
 Ave. No. 2

Name of Owner PAUL GIOVANNI

Labor and Mat'l. Report OCT-14-1972

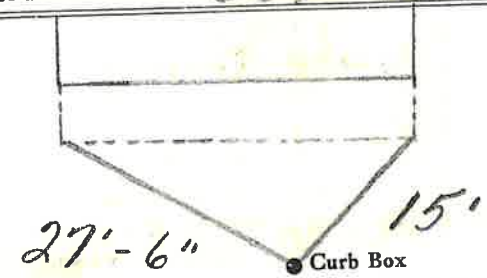

6" Main Elev. of Main at tap 4 1/2'  
 Gate at ● Gate at ●

TAX ID # 309.27-5-1

● Curb Box