


**Labor and Materials**

Copper } Connection.....	1	\$ 2.60
Lead } .....	1	
Curb } Cock Valve } .....	3	\$ 2.27
} T.S. & V. } .....		
Service Box } Short 3/4x4 1/2 } .....		\$ 1.38
Old returned } Long 1 1/2x3 1/2 } .....		
} Buff. or Railway } .....		
27 Ft. 29' } Copper } Pipe at.....	3	\$ 4.86
} Galv. Iron } .....		
} Cast Iron } .....		
Nipples.....	1	\$
Bushings.....		\$
Red'g } Couplings.....		\$
Inc'g } .....		\$
Union.....		\$
Meter.....		\$
Lbs. Br. Stone at.....		\$
Lbs. Sand at.....		\$
Bags Cement at.....		\$
Paving Brick } Mack } at.....		\$
} Red } .....		\$
} Asphalt } .....		\$
Lead Joints at.....		\$
Leadite Joints at.....		\$
3 Hrs. Foreman at.....		\$ 1.88
1.3 Hrs. Common Labor at.....		\$ 5.85
Hrs. Common Labor at.....		\$
Hrs. Mason at.....		\$
Hrs. Mason's Helper at.....		\$
Hrs. Compressor at.....		\$
Compensation Ins.....		\$ .24
Trucking.....		\$ 1.00
Builders' Use of Water Patch.....		\$ 5.00
<b>Added 2' Copper</b>		Total \$ 25.08
<b>10-14-1972</b>		

32-6

Labor and Material Report Dec 23 1971

3 Ormond St

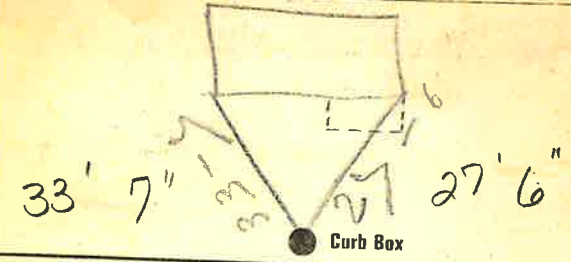

6" Oct-1972

Main Eley of Main at tap 4 1/2'

Gate at ● Curb Box

New House

TAX ID # 309.27-5-2