
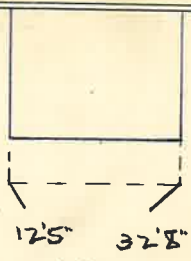


St. Pt. Ave. No. 5
Drville
 Name of Owner _____
 Labor and Mat'l. Report _____ 19____

 12'5" 32'8"
 ● Curb Box
 6" Main Elev. of Main at tap 6
 Gate at ● Gate at
 ● Curb Box
 7' to main

St. Pt. Ave. No. 5
ORMOND
 Name of Owner Walter J. DUNN JR
 Labor and Mat'l. Report OCT 18 1972

 23' 23'
 ● Curb Box
 6" Main Elev. of Main at tap 4 1/2"
 Gate at ● Gate at
 ● Curb Box
 TAX ID # 309.27-2-17
 LSM-5C-6-1-67

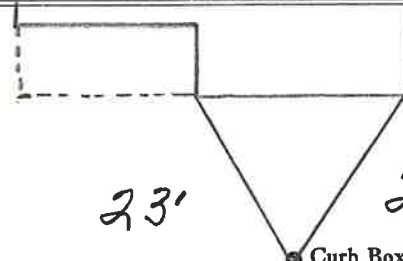