


LABOR AND MATERIALS

1	Copper	Connection	3/4"	\$
1	Lead	Cock	Orisco 1 3/4 in.	\$
1	Curb	Valve	T. S. & V.	\$
1	Service box	Short	3 1/2 x 4 1/2	\$
	Old returned	Long	4 1/2 x 5 1/2	
		Buff or Rdway		
18	Ft. 3/4 in.	Copper	Pipe at	\$
		C. I.		
		C. I.		
	Nipples	in. at		\$
	Bushings	to in. at		\$
	Red'g	Coupl'gs	to in. at	\$
	Inc'g			
	Union	in. at		\$
	Meter	in. at		\$
	Lead Joints	at		\$
	Compound Joints	at		\$
	Maintenance Foreman			\$
	Hrs. Water Maint. Man—1	at		\$
	Hrs. Water Maint. Man—2	at		\$
	Hrs. Garage Foreman	at		\$
	Hrs. Labor—	at		\$
	Hrs. Compressor	at		\$
	Compensation Ins. at \$	per C		\$
	Trucking			\$
	Pay't Patch			\$
	Tap made April 21-65			\$
	By G. S. Ford & Co			\$
	O'head			\$

Orville St. St. Ave. No. 14

Name of Owner
Bernard Falvey

Labor and Mat'l. Report April 21 19 65

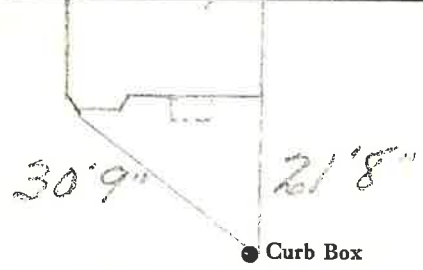

6" Main Elev. of Main at tap 5 1/2'

Gate at • Gate at

• Curb Box

NEW COPPER 1997

TAX ID # 309.27-3-7