

LABOR AND MATERIALS

Copper	} Connection	_____	\$ _____
Lead			
Curb	} Cock Valve T. S. & V.	_____ in.	\$ _____
Service box Old returned	} Short 3½ x 4½ Long 4½ x 5½	_____	\$ _____
19 Ft. 3/4 in.	} Copper G.I. G.I.	Pipe at _____	\$ _____
Nipples	_____ in. at _____	\$ _____	
Bushings	_____ to _____ in. at _____	\$ _____	
Red'g Inc'g	} Coupl'gs _____ to _____ in. at _____	\$ _____	
Union		_____ in. at _____	\$ _____
Meter	_____ in. at _____	\$ _____	
Compound Joints	_____	\$ _____	
Maintenance Foreman	_____	\$ _____	
Hrs. Water Maint. Man—1	at _____	\$ _____	
Hrs. Water Maint. Man—2	at _____	\$ _____	
Hrs. Garage Foreman	at _____	\$ _____	
Hrs. Labor	at _____	\$ _____	
Hrs. Compressor	at _____	\$ _____	
Trucking	_____	\$ _____	
Pav't Patch	_____	\$ _____	
		\$ _____	
		\$ _____	
		\$ _____	
		\$ _____	

ORVILLE


St. 18
~~Pl.~~
 Ave. No.

Name of Owner

TAX ID # 309.27-3-9

Labor and Mat'l. Report

19 97

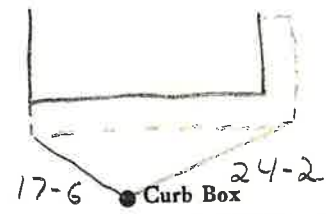

6" Main

Elev. of
Main at tap _____

Gate at ●

● Gate at

● Curb Box