

### LABOR AND MATERIALS

Copper } Connection _____	\$ _____
Lead } _____	\$ _____
Curb } Cock _____	in. \$ _____
} Valve _____	
} T. S. & V. _____	
Service box } Short 3 1/2 x 4 1/2 _____	\$ _____
Old returned } Long 4 1/2 x 5 1/2 _____	\$ _____
11 Ft. 3/4 in. { Copper } Pipe at _____	\$ _____
} C.I. _____	
} C.I. _____	
Nipples _____ in. at _____	\$ _____
Bushings _____ to _____ in. at _____	\$ _____
Red'g } Coupl'gs _____ to _____ in. at _____	\$ _____
Inc'g } _____	\$ _____
Union _____ in. at _____	\$ _____
Meter _____ in. at _____	\$ _____
Compound Joints at _____	\$ _____
Maintenance Foreman _____	\$ _____
Hrs. Water Maint. Man—1 at _____	\$ _____
Hrs. Water Maint. Man—2 at _____	\$ _____
Hrs. Garage Foreman _____ at _____	\$ _____
Hrs. Labor— _____ at _____	\$ _____
Hrs. Compressor at _____	\$ _____
Trucking _____	\$ _____
Pav't Patch _____	\$ _____
_____	\$ _____
_____	\$ _____
36 CRANDALL IN REAR YACHT LOT

ORVILLE

St.

~~Pl~~


Ave: No. 20

Name of Owner \_\_\_\_\_

Labor and Mat'l. Report \_\_\_\_\_

19 97

CRANDALL ST.

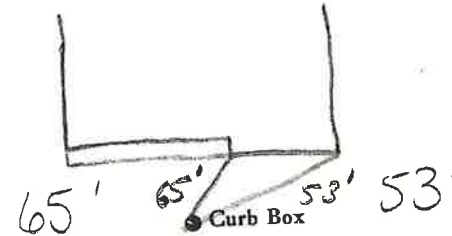

ST.

ORVILLE ST

6" Main

Elev. of

Main at tap \_\_\_\_\_

Gate at ●

● Gate at \_\_\_\_\_

● Curb Box

36 Crandall

TAX ID# 309.27-2-7