

LABOR AND MATERIALS


Copper	} Connection	_____	\$ _____		
Lead					
Curb	} Cock Valve T.S. & V.	_____ in.	\$ _____		
				} Short 3 1/2 x 4 1/2	_____
Service box			\$ _____		
Old returned			\$ _____		
16' 6" Ft.	} Copper G.I. G.I.	} Pipe at _____	\$ _____		
3/4" in.					
Nipples	_____ in. at _____	\$ _____			
Bushings	_____ to _____ in. at _____	\$ _____			
Red'g	} Coupl'gs _____ to _____ in. at _____	\$ _____			
Inc'g					
Union	_____ in. at _____	\$ _____			
Meter	_____ in. at _____	\$ _____			
Compound Joints	at _____	\$ _____			
Maintenance Foreman		\$ _____			
Hrs. Water Maint. Man-1	at _____	\$ _____			
Hrs. Water Maint. Man-2	at _____	\$ _____			
Hrs. Garage Foreman	at _____	\$ _____			
Hrs. Labor	at _____	\$ _____			
Hrs. Compressor	at _____	\$ _____			
Trucking		\$ _____			
Pav't Patch		\$ _____			
		\$ _____			
		\$ _____			
		\$ _____			
		\$ _____			

St. ORVILLE
 Pl. _____
 Ave. No. 22

Name of Owner _____

TAX ID # 309.27-2-8

Labor and Mat'l. Report _____ 1977

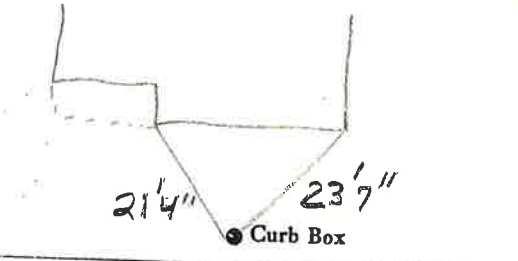

6" Main Elev. of Main at tap _____

Gate at • Gate at •

• Curb Box