


LABOR AND MATERIALS

| | |
|---|--|
| Copper } Connection _____ \$ | |
| Lead } _____ \$ | |
| Curb } Cock _____ in. \$ | |
| } Valve _____ in. \$ | |
| } T. S. & V. _____ in. \$ | |
| Service box } Short 3½ x 4½ _____ \$ | |
| Old returned } Long 4½ x 5½ _____ \$ | |
| 13 Ft. ¾ in. } Copper } Pipe at _____ \$ | |
| } G.I. } _____ \$ | |
| } C.I. } _____ \$ | |
| Nipples _____ in. at _____ \$ | |
| Bushings _____ to _____ in. at _____ \$ | |
| Red'g } Coupl'gs _____ to _____ in. at _____ \$ | |
| Inc'g } _____ to _____ in. at _____ \$ | |
| Union _____ in. at _____ \$ | |
| Meter _____ in. at _____ \$ | |
| _____ at _____ \$ | |
| Compound Joints at _____ \$ | |
| Maintenance Foreman _____ \$ | |
| Hrs. Water Maint. Man—1 at _____ \$ | |
| Hrs. Water Maint. Man—2 at _____ \$ | |
| Hrs. Garage Foreman _____ at _____ \$ | |
| Hrs. Labor— _____ at _____ \$ | |
| Hrs. Compressor at _____ \$ | |
| _____ \$ | |
| Trucking _____ \$ | |
| Pav't Patch _____ \$ | |
| _____ \$ | |
| _____ \$ | |
ORVILLE St. Ave. No. 23

Name of Owner TAX ID # 309.27-1-22

Labor and Mat'l. Report 19 97

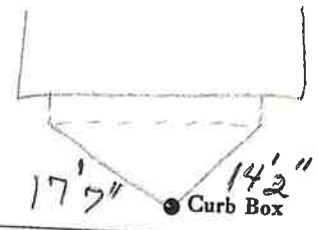

6 Main Elev. of Main at tap Gate at Gate at

● Curb Box