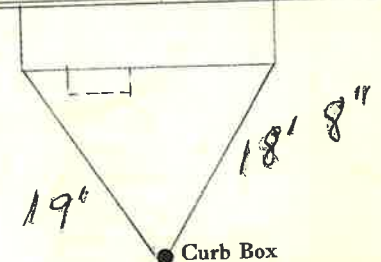


LABOR AND MATERIALS

1 Copper } Connection ^{3/4"} \$ _____
 1 Lead } Cock } 3/4" in. \$ _____
 1 Curb } Valve } T.S. & V. } \$ _____
 1 Service box { Short 3 1/2 x 4 1/2 }
 Old returned { Long 4 1/2 x 5 1/2 }
 { Buff. or Rdway } \$ _____
 12 Ft. ^{3/4"} in. { Copper } Pipe at \$ _____
 { G.I. }
 { C.I. }
 Nipples in. at \$ _____
 Bushings to in. at \$ _____
 Red'g }
 Inc'g } Coupl'gs to in. at \$ _____
 Union in. at \$ _____
 Meter in. at \$ _____
 Lead Joints at \$ _____
 Compound Joints at \$ _____
 Maintenance Foreman \$ _____
 Hrs. Water Maint. Man—1 at \$ _____
 Hrs. Water Maint. Man—2 at \$ _____
 Hrs. Garage Foreman at \$ _____
 Hrs. Labor— at \$ _____
 Hrs. Compressor at \$ _____
 Compensation Ins. at \$ _____ per C. \$ _____
 Trucking \$ _____
 Pav't Patch \$ _____
 Tap by G. J. GORDY Co. \$ _____
 6-22-59 \$ _____
 O'head \$ _____
 \$ _____

✓
 Orville
 St. _____
 Pl. _____
 Ave. No. 24
 Name of Owner
 W. J. Abbott
 Labor and Mat'l. Report June 22 1959

 6" Main Elev. of Main at tap 6'
 Gate at • Gate at
 • Curb Box
 TAX ID # 309.27-2-9
 LSM-5C-2-5 56