

LABOR AND MATERIALS


Copper } Connection _____	\$ _____
Lead } _____	\$ _____
Curb } Cock _____	\$ _____
} Valve _____	in. _____
} T. S. & V. _____	\$ _____
Service box } Short 3 1/2 x 4 1/2 _____	\$ _____
Old returned } Long 4 1/2 x 5 1/2 _____	\$ _____
16 Ft. 3/4 in. } Copper _____	\$ _____
} C.I. _____	\$ _____
} C.I. _____	\$ _____
Nipples _____ in. at _____	\$ _____
Bushings _____ to _____ in. at _____	\$ _____
Red'g } _____	\$ _____
Inc'g } Coupl'gs _____ to _____ in. at _____	\$ _____
Union _____ in. at _____	\$ _____
Meter _____ in. at _____	\$ _____
_____	\$ _____
Compound Joints at _____	\$ _____
Maintenance Foreman _____	\$ _____
Hrs. Water Maint. Man—1 at _____	\$ _____
Hrs. Water Maint. Man—2 at _____	\$ _____
Hrs. Garage Foreman _____ at _____	\$ _____
Hrs. Labor— _____ at _____	\$ _____
Hrs. Compressor at _____	\$ _____
_____	\$ _____
Trucking _____	\$ _____
Pav't Patch _____	\$ _____
_____	\$ _____
_____	\$ _____
_____	\$ _____
_____	\$ _____

ORVILLE

St. _____
 Pl. _____
 Ave. No. 25

Name of Owner _____

Labor and Mat'l. Report _____ 19

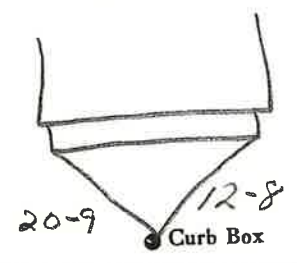

6" Main

Elev. of Main at tap _____

Gate at ●

● Gate at _____

● Curb Box

NEW COPPER-1997