


### LABOR AND MATERIALS

Copper } Connection _____	\$ _____
Lead } _____	\$ _____
Curb } Cock _____	in. \$ _____
} Valve _____	
} T. S. & V. _____	
Service box } Short 3½ x 4½ _____	\$ _____
Old returned } Long 4½ x 5½ _____	\$ _____
12 Ft. ¾ in. } Copper _____	Pipe at \$ _____
} G. F. _____	
} G. F. _____	
Nipples _____ in. at _____	\$ _____
Bushings _____ to _____ in. at _____	\$ _____
Red'g } _____	\$ _____
Inc'g } Coupl'gs _____ to _____ in. at _____	\$ _____
Union _____ in. at _____	\$ _____
Meter _____ in. at _____	\$ _____
_____	\$ _____
Compound Joints at _____	\$ _____
Maintenance Foreman _____	\$ _____
Hrs. Water Maint. Man—1 at _____	\$ _____
Hrs. Water Maint. Man—2 at _____	\$ _____
Hrs. Garage Foreman _____ at _____	\$ _____
Hrs. Labor— _____ at _____	\$ _____
Hrs. Compressor at _____	\$ _____
_____	\$ _____
Trucking _____	\$ _____
Pav't Patch _____	\$ _____
_____	\$ _____
_____	\$ _____
St. \_\_\_\_\_  
 ORVILLE Pl. \_\_\_\_\_  
 Ave. No. 26

Name of Owner \_\_\_\_\_  
 TAX ID # 309.27-2-10

Labor and Mat'l. Report \_\_\_\_\_ 1997

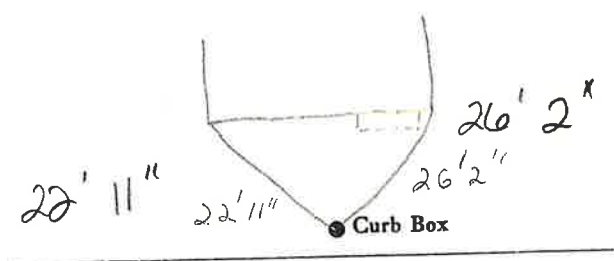

Main	Elev. of Main at tap _____
Gate at ● _____	● Gate at _____
● Curb Box	