


LABOR AND MATERIALS

1 Copper } Connection 3/4" \$
 1 Lead }
 1 Curb } Cock } 3/4 in. Oriseal \$
 } Valve }
 } T.S. & V. }
 1 Service box } { Short 3 1/2 x 4 1/2 } \$
 Old returned } { Long 4 1/2 x 5 1/2 }
 } { Buff or Rdway }
 18 Ft. 3/4 in. } { Copper } Pipe at \$
 } { G.I. }
 } { G.I. }
 Nipples in. at \$
 Bushings to in. at \$
 Red'g }
 Inc'g } Coupl'gs to in. at \$
 Union in. at \$
 Meter in. at \$
 Lead Joints at \$
 Compound Joints at \$
 Maintenance Foreman \$
 Hrs. Water Maint. Man-1 at \$
 Hrs. Water Maint. Man-2 at \$
 Hrs. Garage Foreman at \$
 Hrs. Labor at \$
 Hrs. Compressor at \$
 Compensation Ins. at \$ per C \$
 Trucking \$
 Pav't Patch \$
Tap by Laireau & Co \$
9-15-70 \$
 O'head \$
 \$

St. Orville
 Pt. 27
 Ave. No. 27

Name of Owner S. Gottlieb

Labor and Mat'l. Report Sept 15 1970

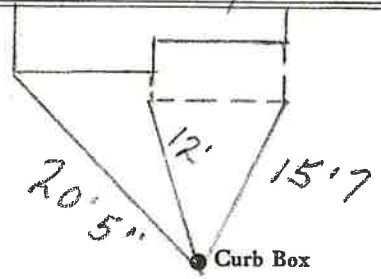

6" Main Elev. of Main at tap 5'
 Gate at • Gate at
18' to main

• Curb Box

TAX ID # 309.27-1-20