

LABOR AND MATERIALS

Copper } Connection _____	\$ _____
Lead } _____	
Curb } Cock _____	in. \$ _____
} Valve _____	
} T. S. & V. _____	
Service box } Short 3 1/2 x 4 1/2 }	
Old returned } Long 4 1/2 x 5 1/2 }	\$ _____
13 Ft. 3/4 in. } Copper } Pipe at _____	\$ _____
} <del>C.I.</del>	
} <del>C.I.</del>	
Nipples _____ in. at _____	\$ _____
Bushings _____ to _____ in. at _____	\$ _____
Red'g } _____	
Ine'g } Coupl'gs _____ to _____ in. at _____	\$ _____
Union _____ in. at _____	\$ _____
Meter _____ in. at _____	\$ _____
_____	\$ _____
Compound Joints at _____	\$ _____
Maintenance Foreman _____	\$ _____
Hrs. Water Maint. Man—1 at _____	\$ _____
Hrs. Water Maint. Man—2 at _____	\$ _____
Hrs. Garage Foreman _____ at _____	\$ _____
Hrs. Labor _____ at _____	\$ _____
Hrs. Compressor at _____	\$ _____
_____	\$ _____
Trucking _____	\$ _____
Pav't Patch _____	\$ _____
_____	\$ _____
_____	\$ _____
_____	\$ _____
_____	\$ _____

ORVILLE


St. 28  
 Pl. \_\_\_\_\_  
 Ave. No. \_\_\_\_\_

Name of Owner

TAX ID # 309.27-2-11

Labor and Mat'l. Report

19 94

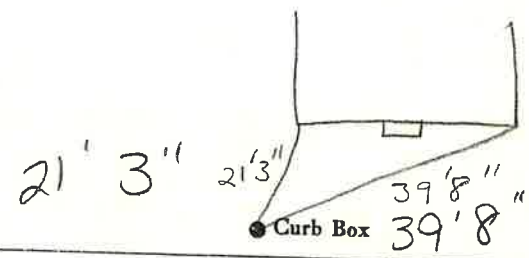

6" Main

Elev. of Main at tap \_\_\_\_\_

Gate at ●

● Gate at

● Curb Box

RENEWAL TAP