

LABOR AND MATERIALS


1 Copper } Connection ^{3/4"} \$
 Lead }
 1 Curb } Cock } 3/4 in. ^{ORISER 1} \$
 Valve }
 1 Service box } { Short 3 1/2 x 4 1/2 } \$
 Old returned } { Long 2 1/2 x 3 1/2 } \$
 1 1/4^{03/4} Ft. 3/4 in. } { Copper } Pipe at \$
 } { } \$
 Nipples in. at \$
 Bushings to in. at \$
 Red'g }
 Inc'g } Coupl'gs to in. at \$
 Union in. at \$
 Meter in. at \$
 Lead Joints at \$
 Compound Joints at \$
 Maintenance Foreman \$
 Hrs. Water Maint. Man-1 at \$
 Hrs. Water Maint. Man-2 at \$
 Hrs. Garage Foreman at \$
 Hrs. Labor at \$
 Hrs. Compressor at \$
 Compensation Ins. at \$ per C \$
 Trucking \$
 Pav't Patch \$
 TAP MADE BY GIFFORD & CO \$
 MAY-19-1975 \$
 O'head \$

ORVILLE

St. No. 29
 Ave. No. 29

Name of Owner
 Michael P. White

Labor and Mat'l. Report MAY 19 1975

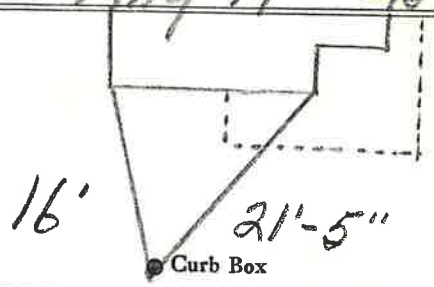

6" Main Elev. of Main at tap 5'

Gate at • Gate at

• Curb Box

TAX ID# 309.27-1-19