

LABOR AND MATERIALS

Copper } Connection _____ \$
 Lead }
 Curb } Cock Valve } _____ in. \$
 } T. S. & V. }
 Service box { Short 3½ x 4½ }
 Old returned { Long 4½ x 5½ } _____ \$
 6 Ft. 3/4 in. { Copper } Pipe at _____ \$
 } G.I. }
 } C.I. }
 Nipples _____ in. at _____ \$
 Bushings _____ to _____ in. at _____ \$
 Red'g }
 Inc'g } Coupl'gs _____ to _____ in. at _____ \$
 Union _____ in. at _____ \$
 Meter _____ in. at _____ \$
 _____ \$
 Compound Joints at _____ \$
 Maintenance Foreman _____ \$
 Hrs. Water Maint. Man—1 at _____ \$
 Hrs. Water Maint. Man—2 at _____ \$
 Hrs. Garage Foreman _____ at _____ \$
 Hrs. Labor _____ at _____ \$
 Hrs. Compressor at _____ \$
 _____ \$
 Trucking _____ \$
 Pav't Patch _____ \$
 _____ \$
 _____ \$
ORVILLE


St. Ave. No. 30

Name of Owner

TAX ID # 309.27-2-12

Labor and Mat'l. Report

1977

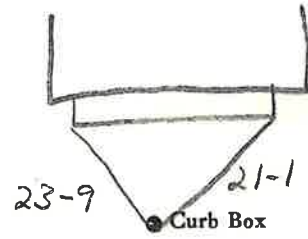

6" Main

Elev. of Main at tap

Gate at ●

● Gate at

● Curb Box