

LABOR AND MATERIALS

Copper } Connection _____	\$ _____
Lead } _____	\$ _____
Curb } Cock } _____ in.	\$ _____
} Valve } _____	
} T. S. & V. } _____	
Service box } Short 3½ x 4½ } _____	\$ _____
Old returned } Long 4½ x 5½ } _____	\$ _____
15 Ft. ¾ in. } Copper } Pipe at _____	\$ _____
} GI } _____	
} GI } _____	
Nipples _____ in. at _____	\$ _____
Bushings _____ to _____ in. at _____	\$ _____
Red'g } Coupl'gs _____ to _____ in. at _____	\$ _____
Inc'g } _____	
Union _____ in. at _____	\$ _____
Meter _____ in. at _____	\$ _____
_____	\$ _____
Compound Joints at _____	\$ _____
Maintenance Foreman _____	\$ _____
Hrs. Water Maint. Man—1 at _____	\$ _____
Hrs. Water Maint. Man—2 at _____	\$ _____
Hrs. Garage Foreman _____ at _____	\$ _____
Hrs. Labor— _____ at _____	\$ _____
Hrs. Compressor at _____	\$ _____
_____	\$ _____
Trucking _____	\$ _____
Pav't Patch _____	\$ _____
_____	\$ _____
_____	\$ _____
_____	\$ _____
_____	\$ _____

ORVILLE


St. ~~PK~~
Ave. No. 31

Name of Owner

TAX ID # 309.27-1-18

Labor and Mat'l. Report

1977

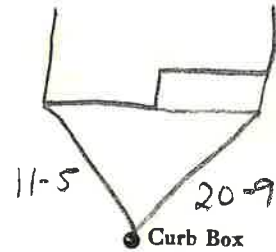

6" Main

Elev. of
Main at tap _____

Gate at ●

● Gate at _____

● Curb Box