

LABOR AND MATERIALS

Copper	} Connection	_____	\$ _____		
Lead		_____	\$ _____		
Curb	} Cock	_____ in.	\$ _____		
				} Valve	_____
Service box	} Short 3 1/2 x 4 1/2	_____	\$ _____		
Old returned				} Long 4 1/2 x 5 1/2	_____
15 Ft. 3/4 in.	} Copper	} Pipe at	\$ _____		
				} G.I.	_____
Nipples	_____ in. at	\$ _____			
Bushings	_____ to _____ in. at	\$ _____			
Red'g	} Coupl'gs	_____ to _____ in. at	\$ _____		
Inc'g				_____ in. at	\$ _____
Union	_____ in. at	\$ _____			
Meter	_____ in. at	\$ _____			
Compound Joints	_____ at	\$ _____			
Maintenance Foreman	_____ at	\$ _____			
Hrs. Water Maint. Man-1	_____ at	\$ _____			
Hrs. Water Maint. Man-2	_____ at	\$ _____			
Hrs. Garage Foreman	_____ at	\$ _____			
Hrs. Labor	_____ at	\$ _____			
Hrs. Compressor	_____ at	\$ _____			
Trucking	_____	\$ _____			
Pav't Patch	_____	\$ _____			
		\$ _____			
		\$ _____			
ORVILLE


St. ~~Pl.~~ Ave. No. 33

Name of Owner

TAX ID # 309.27-1-17

Labor and Mat'l. Report

19 97

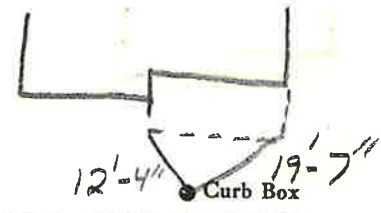

6" Main

Elev. of Main at tap

Gate at ●

● Gate at

● Curb Box