

LABOR AND MATERIALS


1	Copper	} Connection	3/4"	\$ 308	
	Lead				
1	Curb	} Cock	3/4 in.	\$ 389	
					} Valve
Same	Service box	} Short 3 1/2 x 4 1/2		\$ 432	
	Old returned				} Long 4 1/2 x 5 1/2
103'	3/4 in.	} Copper	} Pipe at 45	\$ 360	
					} G. I.
	Nipples	in. at	\$		
	Bushings	to in. at	\$		
	Red'g				
	Inc'g	Coupl'gs to in. at	\$		
	Union	in. at	\$		
	Meter	in. at	\$		
	Lead Joints at		\$		
	Compound Joints at		\$		
11	Maintenance Foreman	1.937	\$ 2131		
	Hrs. Water Maint. Man-1 at		\$		
4	Hrs. Water Maint. Man-2 at	1613	\$ 645		
2 1/2	Hrs. Garage Foreman at	3033	\$ 508		
11	Hrs. Labor-2 at	1481	\$ 1629		
9	Hrs. Compressor at	lab-130	\$ 1170		
	Compensation Ins. at \$5626 per C.		\$ 346		
	Trucking		\$ 150		
	Pav't Patch		\$ 1608		
	Tap by Gifford & Co.		\$		
	4-5-6 N. Miller St		\$		
	Kosmer 11-2-56		\$		
	O'head PUT IN PIPE		\$		
			\$ 9676		

89.08

St. Orville
Pl. Ave. No. 34

Name of Owner BANKOWSKI

Labor and Mat'l. Report Nov. 5 1956

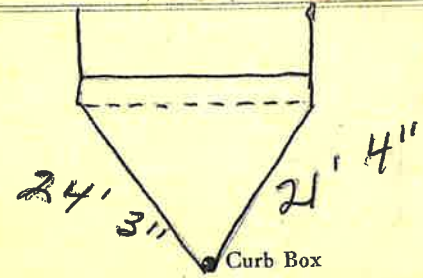

6" Main Elev. of Main at tap 5'
Gate at • Gate at
10' 3" to main

• Curb Box

TAX ID# 309:27-2-14