

LABOR AND MATERIALS

1	Copper	{	Connection	3/4	\$	2.87	
	Lead	{		4			
1	Curb	{	Cock Valve T.S. & V.	3/4 in.	\$	3.62	
1	Service box	{	Short 3 1/2 x 4 1/2	Same	\$	—	
	Old returned	{	Long 4 1/2 x 5 1/2				
		{	Buff or Rdway				
7	Ft.	3/4 in.	{	Copper	Pipe at	\$	6.08
			{	G.I.			
			{	G.I.			
	Nipples	in. at			\$		
	Bushings	to in. at			\$		
	Red'g Inc'g	{	Coupl'gs	to in. at	\$		
	Union	in. at			\$		
	Meter	in. at			\$		
	Lead Joints at				\$		
	Compound Joints at				\$		
	Hrs. Water Maint. Man-1 at				\$		
5	Hrs. Water Maint. Man-2 at	1.02			\$	5.10	
23	Hrs. Labor— at	91			\$	20.93	
	Hrs. Labor— at				\$		
2	Hrs. Compressor at	1.20			\$	2.40	
	Compensation Ins. at \$ 2.18 per C.				\$.57	
	Trucking				\$	2.00	
	Pav't Patch				\$	14.85	
	Tap by Maguire				\$		
	O'head				\$		
					\$	58.42	

120.


St. Orville Ave. No. 7

Name of Owner

Burns

Labor and Mat'l. Report

Nov 1 1949

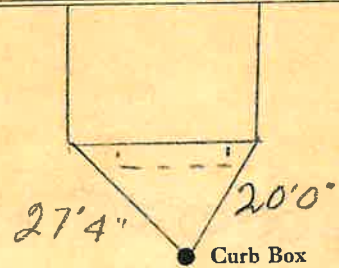

6" Main Elev. of Main at tap 5'

Gate at ● Gate at ●

● Curb Box

TAX ID # 302.20-20-16