


LABOR AND MATERIALS

1	Copper	} Connection <sup>3/4"</sup>	\$
1	Lead		\$
1	Curb	} Cock Valve T.S. & V. } <sup>3/4</sup> in.	\$
1	Service box		} Short 3 1/2 x 4 1/2 Long 4 1/2 x 5 1/2 Buff or Rdway }
17	Old returned		
17	Ft. <sup>3/4</sup> in.	} Copper C.I. C.I. }	Pipe at \$
	Nipples		in. at \$
	Bushings	to in. at \$	
	Red'g } Inc'g }	Coupl'gs to in. at \$	
	Union	in. at \$	
	Meter	in. at \$	
	Lead Joints	at \$	
	Compound Joints	at \$	
	Maintenance Foreman	\$	
	Hrs. Water Maint. Man-1	at \$	
	Hrs. Water Maint. Man-2	at \$	
	Hrs. Garage Foreman	at \$	
	Hrs. Labor	at \$	
	Hrs. Compressor	at \$	
	Compensation Ins. at \$	per C \$	
	Trucking	\$	
	Pav't Patch	\$	
	Tap by Gifford	\$	
	1st Co. 2-21-63	\$	
	O'head	\$	
		\$	

St. Orville  
 Pt. 37  
 Ave. No. 37

Name of Owner Johns.

Labor and Mat'l. Report Feb, 21 1963

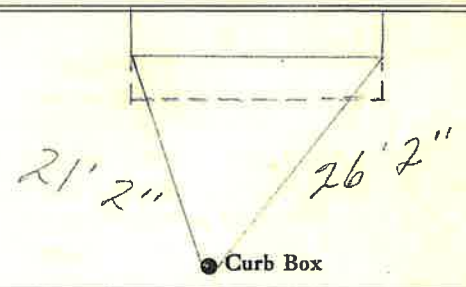

6" Main Elev. of Main at tap 5'  
 Gate at • Gate at •

• Curb Box  
 TAX ID# 309.27-1-15