

LABOR AND MATERIALS

Copper } Connection \$
 Lead }
 Curb { Cock Valve } in. \$
 { T. S. & V. }
 Service Box { Short 3½x4½ } \$
 Old returned { Long 4½x5½ }
 { Buffer Rdway }
 Ft. in. { Copper } Pipe at \$
 { Galv Iron }
 { Cast Iron }
 Nipples in. at \$
 Bushings to in. at \$
 Red'g } Couplings to in. at \$
 Inc'g }
 Union in. at \$
 Meter in. at \$
 Lead Joints at \$
 Leadite Joints at \$
 Hrs. Foreman at \$
 Hrs. Chauffeur at \$
 Hrs. Tapper at \$
 Hrs. Labor at \$
 Hrs. Labor at \$
 Hrs. Compressor at \$
 Compensation Ins. \$
 Trucking \$
 Builders Use of Water \$
 \$
 \$
St. _____
Pl. _____
Ave. No. 38

Drville

Name of Owner
TAX ID # 309.27-2-16

Labor and Mat'l. Report SEP 6 - 1939 19

6" Main Elev. of Main at tap.....
 Gate at ● ● Gate at

● Curb Box

Labor and Material Report

Oct 17

1922

38 Orville at 1/2 tap
No Measurement

● Curb Box

4" Main

Elev. of Main at tap 4/10

Gate at ●

● Gate at


● Curb Box

Labor and Material Report

July 24

19

38 Orville St

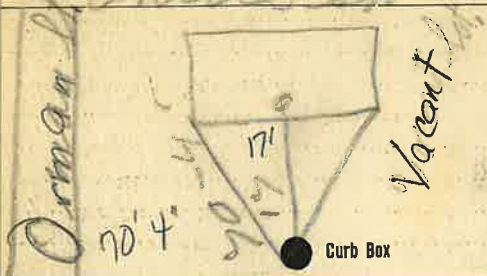

● Curb Box

Orville St.

4" Main

Elev. of Main at tap 4/10

Gate at ●

● Gate at

● Curb Box

Labor and Materials

1	Lead Connection	\$
1	Curb Cock	\$
1	Service Box { Short 3 1/2 x 4 1/2 Old returned { Long 4 1/2 x 5 1/2 Buffalo	\$
11	Ft. in. G. I. Pipe at	\$
1	Nipples 1/2 in. at	\$
	Bushings in. at	\$
1	Red'g Coup 1/2 to 1/2 in. at	\$
	Inc'g Coup to in. at	\$
	Union in. at	\$
	Meter in. at	\$
	Cu. Yds. Br. Stone at	\$
	Cu. Yds. Sand at	\$
	Bags Cement at	\$
	Pav. Brick { Mack Red Asphalt } at	\$
1	Hrs. Foreman at	\$
1	Hrs. Com. Labor at	\$
	Hrs. Mason at	\$
	Hrs. at	\$
	Hrs. at	\$
1/2	Builders' Use of Water	\$
	at	\$
	at	\$
	at	\$
	at	\$
	Total	\$ 94.18

Labor and Materials

1	Lead Connection 3	\$
1	Curb Cock 1	\$
1	Service Box { Short 3 1/2 x 4 1/2 Old returned { Long 4 1/2 x 5 1/2 Buffalo	\$
9	Ft. in. G. I. Pipe at	\$
	Nipples in. at	\$
	Bushings to in. at	\$
	Red'g Coup to in. at	\$
	Inc'g Coup to in. at	\$
	Union in. at	\$
	Meter in. at	\$
	Cu. Yds. Br. Stone at	\$
	Cu. Yds. Sand at	\$
	Bags Cement at	\$
	Paving Brick { Mack Red Asphalt } at	\$
3	Hrs. Foreman at	\$
9	Hrs. Common Labor at	\$
	Hrs. Mason at	\$
	Hrs. at	\$
	Hrs. at	\$
20	Builders' Use of Water	\$
	at	\$
	at	\$
	at	\$
	at	\$
	Total	\$ 123.82