

LABOR AND MATERIALS

1	Copper	} Connection	3/4"	\$
	Lead			
1	Curb	} Cock Valve T.S. & V.	3/4 in.	\$
1	Service box	} Short 3 1/2 x 4 1/2	4' Oriseal	\$
	Old returned			
15 1/2	Ft. 3/4 in.	} Copper G.I. C.I.	Pipe at	\$
	Nipples	in. at	\$	
	Bushings	to in. at	\$	
	Red'g			
	Inc'g	Coupl'gs to in. at	\$	
1	Union	3/4 in. at	3 Piece Coupling	\$
	Meter	in. at	\$	
	Lead Joints	at	\$	
	Compound Joints	at	\$	
	Maintenance Foreman		\$	
	Hrs. Water Maint. Man-1	at	\$	
	Hrs. Water Maint. Man-2	at	\$	
	Hrs. Garage Foreman	at	\$	
	Hrs. Labor	at	\$	
	Hrs. Compressor	at	\$	
	Compensation Ins. at \$	per C	\$	
	Trucking		\$	
	Pav't Patch		\$	
	Tap by Laveau & Co.		\$	
	Aug. 1-70.		\$	
	O'head		\$	

Orville


St. Pl. Ave. No. 39

Name of Owner

Nemeyer

Labor and Mat'l. Report

Aug. 1 1970

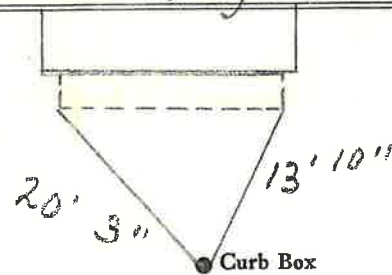

6.11 Main

Elev. of Main at tap 5'

Gate at •

• Gate at

• Curb Box

TAX ID # 309.27-1-14