


July 8
Labor and Material Report 1924

47 Orville St.

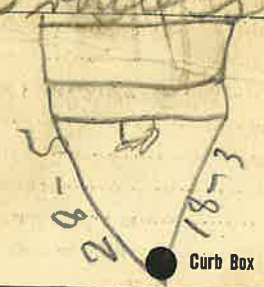


6 Main Elev. of Main at tap 4
Gate at ● Gate at ●

● Curb Box

St. Orville Pl. Ave. No. 47

Name of Owner
TAX ID# 309.7-9-23

Labor and Mat'l. Report SEP 6 - 1939 19

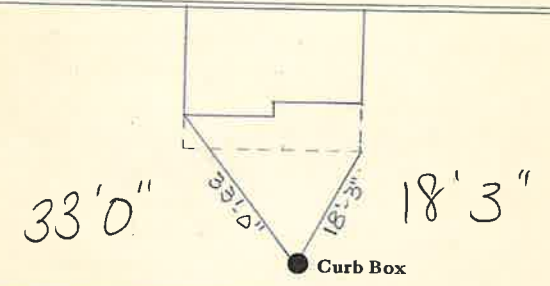

Main Elev. of Main at tap
Gate at ● Gate at ●

● Curb Box

