


LABOR AND MATERIALS

1	Copper	} Connection	3/4"	\$
	Lead			
1	Curb	} Cock Valve	1/4" in.	\$
		T.S. & V.		
1	Service box	} Short 3 1/2 x 4 1/2		\$
	Old returned			
		Long 4 1/2 x 5 1/2		
		Buff or Rdway		
25	Ft. 3/4 in.	} Copper		\$
		G.I.		
		G.I.		
	Nipples	in. at	\$	
	Bushings	to in. at	\$	
	Red'g } Inc'g }	Coupl'gs	to in. at	\$
	Union	in. at	\$	
	Meter	in. at	\$	
	Lead Joints	at	\$	
	Compound Joints	at	\$	
	Maintenance Foreman		\$	
	Hrs. Water Maint. Man-1	at	\$	
	Hrs. Water Maint. Man-2	at	\$	
	Hrs. Garage Foreman	at	\$	
	Hrs. Labor	at	\$	
	Hrs. Compressor	at	\$	
	Compensation Ins. at \$	per C	\$	
	Trucking		\$	
	Pav't Patch		\$	
	Tap by Gifford & Co.			\$
	6-20-67.			\$
	O'head		\$	
			\$	

St. \_\_\_\_\_  
 Pl. \_\_\_\_\_  
 Ave. No. 4-8

Orville  
 Name of Owner: Geo. G. Norman

Labor and Mat'l. Report June 20 1967

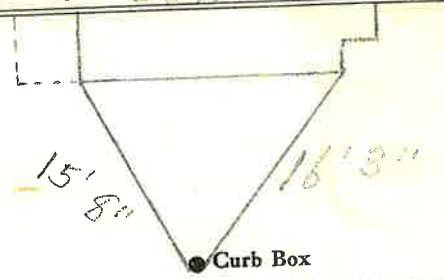

6" Main Elev. of Main at tap 5'  
 Gate at • Gate at •

• Curb Box

TAX ID # 309.7-11-6