

LABOR AND MATERIALS

Copper } Connection		\$
Lead }		
Curb } Cock		
} Valve	in.	\$
} T. S. & V.		
Service box } Short 3½ x 4½		
Old returned } Long 4½ x 5½		\$
23 Ft. 3/4 in. } Copper	Pipe at	\$
} G.I.		
} G.I.		
Nipples	in. at	\$
Bushings	to in. at	\$
Red'g } Coupl'gs	to in. at	\$
Ino'g }		
Union	in. at	\$
Meter	in. at	\$
		\$
Compound Joints	at	\$
Maintenance Foreman		\$
Hrs. Water Maint. Man-1	at	\$
Hrs. Water Maint. Man-2	at	\$
Hrs. Garage Foreman	at	\$
Hrs. Labor	at	\$
Hrs. Compressor	at	\$
		\$
Trucking		\$
Pav't Patch		\$
		\$
		\$
ORVILLE


St. Pl. Ave. No. 54

Name of Owner

TAX ID # 309.7-11-8

Labor and Mat'l. Report

19

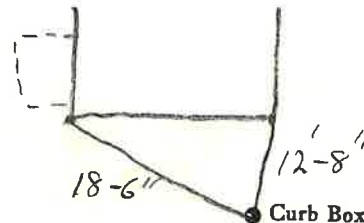

6 Main

Elev. of Main at tap

Gate at ●

● Gate at

● Curb Box

RENEWAL TAP 12-20-94