


LABOR AND MATERIALS

1 Copper { Connection  $\frac{3}{4}$  } \$  
 Lead { }  
 1 Curb { Cock Valve }  $\frac{3}{4}$  in. \$  
 T. S. & V. { }  
 1 Service Box { Short  $3\frac{1}{2} \times 4\frac{1}{2}$  } \$  
 Old returned { Long  $4\frac{1}{2} \times 5\frac{1}{2}$  }  
 Buff. or Rdway { }  
 22 Ft.  $\frac{3}{4}$  in. { Copper } Pipe at \$  
 { Galv Iron }  
 { Cast Iron }  
 Nipples in. at \$  
 Bushings to in. at \$  
 Red'g } Couplings to in. at \$  
 Inc'g { }  
 Union in. at \$  
 Meter in. at \$  
 Lead Joints at \$  
 Leadite Joints at \$  
 Hrs. Foreman at \$  
 Hrs. Chauffeur at \$  
 Hrs. Tapper at \$  
 Hrs. Labor at \$  
 Hrs. Labor at \$  
 Hrs. Compressor at \$  
 Compensation Ins. \$  
 Trucking \$  
 Builders Use of Water \$  
 Apply Person \$  
 \$  
 \$  
 \$

13076  
 ✓  
 St. Orville  
 Ave. No. 58

Name of Owner  
Shea

Labor and Mat'l. Report Oct 12 1936

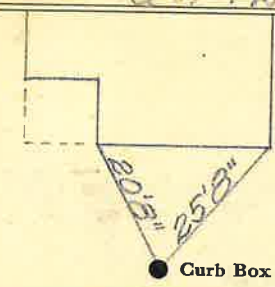

6 Main Elev. of Main at tap 4  
 Gate at ● Gate at ●

● Curb Box  
 TAX ID# 309.7-11-1D

*all sheet out*

Labor and Materials

1	Copper } Connection $3/4$ "	\$ 96
1	Lead } Cock	
1	Curb { Valve } $3/4$ " in	\$ 133
	{ T.S.&V. }	
1	Service Box { Short $3\frac{1}{2} \times 4\frac{1}{2}$	\$ 135
	{ Long $4\frac{1}{2} \times 5\frac{1}{2}$	
	{ Buff. or R.W. }	
22	ft. $3/4$ " in. { Copper } Pipe at 15	\$ 270
	{ Galv. Iron }	
	{ Cast Iron }	
	Nipples ..... in. at	\$
	Bushings ..... to ..... in. at	\$
	Red'g } Couplings..... to ..... in. at	\$
	Inc'g }	
	Union..... in. at	\$
	Meter..... in. at	\$
	Lbs. Br. Stone at	\$
	Lbs. Sand at	\$
	Bags Cement at	\$
	Paving Brick { Mack } at	\$
	{ Red }	
	{ Asphalt }	
	Lead Joints at	\$
	Leadite Joints at	\$
	Hrs. Foreman at	\$
	Hrs. Common Labor at	\$
	Hrs. Common Labor at	\$
	Hrs. Mason at	\$
	Hrs. Masons Helper at	\$
	Hrs. Compressor at	\$
	Compensation Ins	\$
	Trucking	\$
	Builders Use of Water	\$
Total \$.....		

130

Labor and Material Report

1924

58 1110 St 3/4 7/4

Shea



See other  
Card 10-17-36

Curb Box

6" Main

Elev. of  
Main at tap 4

Gate at ●

● Gate at

Old tap shut off

Curb Box

1100

Sh