

### LABOR AND MATERIALS

Copper	}	Connection		\$	
Lead					
Curb	}	Cock	in.	\$	
		Valve			
		T. S. & V.			
Service box	}	Short $3\frac{1}{2} \times 4\frac{1}{2}$		\$	
Old returned		Long $4\frac{1}{2} \times 5\frac{1}{2}$			
<del>9</del> Ft. $3\frac{1}{4}$ in.	}	Copper	Pipe at	\$	
<del>6 FT 6 IN</del>		G.I.			
	}	G.I.		\$	
Nipples		in. at		\$	
Bushings		to in. at		\$	
Red'g	}	Coupl'gs	to in. at	\$	
Inc'g					
Union		in. at		\$	
Meter		in. at		\$	
				\$	
Compound Joints		at		\$	
Maintenance Foreman				\$	
Hrs. Water Maint. Man-1		at		\$	
Hrs. Water Maint. Man-2		at		\$	
Hrs. Garage Foreman		at		\$	
Hrs. Labor		at		\$	
Hrs. Compressor		at		\$	
				\$	
Trucking				\$	
Pav't Patch				\$	
				\$	
				\$	
				\$	
				\$	


ORVILLE

St. 9  
Pt. 9  
Ave. No. 9

Name of Owner \_\_\_\_\_

Labor and Mat'l. Report \_\_\_\_\_

1997

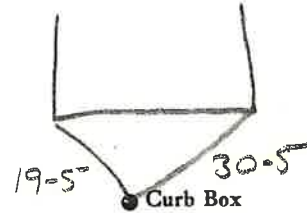

6" Main

Elev. of Main at tap \_\_\_\_\_

Gate at ● ● Gate at

TAX ID # 302.20.20.15

● Curb Box